

**RECORD DRAWING**

This Record Drawing, reflecting changes in the work made during construction, is based on data furnished by the Contractor(s) to the Engineer. The Engineer shall not be held responsible for the accuracy or completeness of the information provided by the contractor.


DANIEL W. KONSTANSKI  
LICENSE No. 18462  
PROFESSIONAL ENGINEER  
DELAWARE

NOTES:  
 1. MIN. 1" CLEARANCE ON ALL SIDES EXCEPT AS OTHERWISE NOTED.  
 2. LINK SEALS AT ALL PENETRATIONS.  
 3. PIPE ELEVATION TO BE 36" BELOW PROPOSED GRADE.

**ARTESIAN**  
ARTESIAN WASTEWATER MANAGEMENT, INC.

664 Churchmans Road  
Newark, Delaware 19702  
P.O. Box 15004, Wilmington, Delaware 19850  
Phone: (302) 453-6900 Fax: (302) 453-5800

REVISIONS	DESCRIPTION	BY	DATE
1	Minor design & label revisions	HRH	5/10/17
2	Rev. per DNR/EC comments dated 5/22/17	KEW	6/28/17
3	Rev. per DNR/EC comments dated 7/21/17	KEW	8/22/17
4	Rev. per SCD comments dated 8/11/17	KEW	8/22/17
5	REV. PER ALLENS COMMENTS	KEG	10/24/17

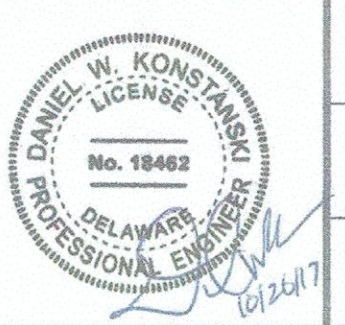

Date:	1/11/17	Checked By:	DK	Sheet:	FM-2
Scale:	1"=40'	Page & Grid:		Hundred:	BROADKILL
Drawn By:	HRH / OTHERS	CAD File:	ONSITE PLANS.dwg	Budget No.:	3002573

**FORCEMAIN PIPING PLAN**  
ALLEN-HARIM LLC, HARBESON

SUSSEX COUNTY STATE OF DELAWARE

40 0 40 80 120

C:\ENR\PROJECTS\706 SUSSEX COUNTY WASTEWATER, ALLEN HARIM LLC\DRAWING\CIVIL\DWG\SHEETS\ONSITE PLANS.dwg, SHEET 3, 10/26/2017 3:45:37 PM