

**SEWAGE DISPOSAL
SYSTEM
APPLICATION / PERMIT**

STATE OF DELAWARE
DEPARTMENT OF NATURAL RESOURCES
AND ENVIRONMENTAL CONTROL



Owner's Name: Tomas B. & Suzanne J. Noll Phone: 736-0898
 Address: 705 Maple Parkway, Dover, DE 19901
 Project Location: Noll's Mobile Home Park; West side of Kent CR 97; just South of CR 1178 Tax Map #: KH 53.00-01-12.03
 Designer: Byron H. Jefferson License #: C 519
 Designer's Address: Byron Jefferson's Engr. Services
P.O. Box 5061 Lincoln, DE 19960 Phone: (302) 422-9568

I hereby affirm that the information provided on this document is accurate and complete.

7/17/92

Designer's Signature

Date

<input type="checkbox"/> - No Water Course Within 500'	<input checked="" type="checkbox"/> - No Central Sewer Available	Average Percolation Rate: <u>30 MPI - Assigned</u> Gallon Per Day Flow: <u>2,400 (8 MHS x 300 GPD each)</u>
<input checked="" type="checkbox"/> - Water Course <u>100+</u> Ft. From Tile Field (ditch)	<input type="checkbox"/> - Central Water Supplied	Minimum Square Ft. Required: <u>5,521.1</u> Square Ft. Proposed: <u>6,132 total (3 beds)</u>

- DRAW CROSS-SECTION BELOW -

D.N.R.E.C.
APPROVED
PERMIT# C 4009-92 K
SEE PERMIT CONDITIONS

--- SEE ATTACHED ---

**U.I.C.
CODE
5W32**

CONSTRUCTION PLAN

Scale: 1" = _____ ft.

Indicate
North:

D.N.R.E.C.
APPROVED
PERMIT# C4009-92K
SEE PERMIT CONDITIONS



--- SEE ATTACHED ---

1. One (1) 2,800 gallon dosing chamber
2. Four (4) 1,500 gallon septic tanks
3. Disposal area (3 sand mounds) with all piping and appurtenances

Owner's Signature Yomas J.M. Suzanne J. Noll Date: 7/17/92


FOR OFFICIAL USE ONLY DO NOT WRITE BELOW THIS LINE

Pursuant to provision of Title 7, Part VII, Del. Code Annotated, permission is granted to construct, operate and maintain (see above) for a

Mobile Home Park as shown above. All current regulations governing septic tank sewage disposal systems must be followed. All conditions attached to this permit must be observed.

This permit expires 09-30-93 for construction, and Sept. 30, 2002 for operation and maintenance.

09-30-92
Date

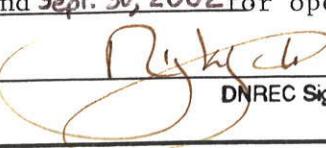DNREC Signature of Approval

THIS PERMIT WILL BE REVOKED UPON VIOLATION OF ANY OF THE BELOW MARKED CONDITIONS.

1. THE DIVISION OF WATER RESOURCES SHALL BE NOTIFIED WHEN THE INSTALLATION IS COMPLETE AND PRIOR TO COVERING THE APPLICANT SHALL CALL THE DIVISION OF ENVIRONMENTAL CONTROL WHEN THE INSTALLATION IS READY FOR INSPECTION. REPRESENTATIVES OF THE DIVISION MAY INSPECT SUCH WORK DURING CONSTRUCTION.
2. Connections or additions to the proposed system other than those proposed on the plans will not be allowed without prior approval from the Division.
3. Roof downspouts, foundation drains, area drains, storm sewers, combined sewers or appurtenances thereto, or any sewer or device carrying or discharging storm water, surface water, groundwater, or cooling water or oil, shall not be connected to this system.
4. The owner shall connect to the county or municipal sewer system if and when such services become available. At such time, this permit becomes void unless the Division approves continued operation.
5. This system shall be maintained in such a manner as to prevent surfacing, pooling and/or discharge of wastewater to any surface waters. If this system produces obnoxious odors which are considered to be a public nuisance, the applicant shall, with the approval of the Division, take necessary steps to eliminate such odors.
6. This permit does not cover the structural stability of the unit.
7. The sites of the initial and replacement absorption facilities shall not be covered by asphalt or concrete or subject to vehicular traffic or any activity which would adversely affect the soils. These sites shall be maintained so that they are free from encroachments by accessory buildings and additions to the main building.
8. Trees and shrubs shall not be planted within 10 feet of the perimeter of the disposal area, but may be planted on fill extensions. All trees and shrubs shall be located to prevent root intrusion into the disposal area and components of the system.
9. The bottom of the seepage area (stone) shall be installed no deeper than 24 inches ~~below~~ ^{above} the ground surface. See cross-section for details.

Permit Conditions Continued

10. X All minimum isolation distances listed on Exhibit C of the 1985 Regulations Governing the Design, Installation and Operation of On-Site Wastewater Treatment and Disposal shall be adhered to.
11. X This system shall not pollute or otherwise interfere with any groundwater supplies.
12. X The average daily discharge of this system is restricted to 2,400 gallons.
13. X This facility shall not be constructed in any highway right-of-way.
14. X The septic tanks shall be pumped by a licensed liquid waste hauler every 3 years.
15. _____ Applicant shall attempt to complete construction as soon as possible.
16. _____ Barriers shall be installed to prevent vehicular traffic from crossing the disposal system.
17. _____ The existing septic tank must be uncovered and opened for inspection. The tank must be _____ gallons or larger with two compartments and baffles or replaced with the same.
18. X A minimum of 16 inches of porous fill must be used to cover the disposal system and must extend 8 feet beyond the edges of the disposal area in all directions. Porous fill must be on-site during inspection.
19. X The natural ground surface must be scraped and roughed in a 10 foot perimeter around the disposal area PRIOR to installation of the seepage system.
20. X The engineer shall be on site to inspect construction, conduct equipment testing and provide as-built drawings.
21. X All electrical connections shall be waterproof and corrosion resistant. Controls for systems larger than 500 gallons per day shall also be explosion proof.
22. X The septic tank, dosing chamber and seepage area shall be installed according to the plans and specifications contained on pages 6 thru 22 of the permit.

Permit Conditions Continued

23. If wellpointing is required during construction, the wells must be installed by a licensed well driller and a permit to construct such wells must first be obtained from the Water Resources Section.

24. A minimum area of 2.4 acres shall remain pervious and available for groundwater recharge after total project completion. This net pervious area shall be maintained so that it remains unpaved and free from encroachments by accessory buildings and additions to the main building.

25. There shall be NO soil disturbance to the LPP site except the minimum required for installation.

26. Lateral and manifold lines shall be installed so that all lines drain to the dosing chamber after completion of the pump cycle.

27. Lateral end caps shall be removed annually and each lateral back flushed with approximately 50 gallons of clean water. End caps shall then be replaced.


28. THE SYSTEM MUST BE INSTALLED BY A LICENSED CLASS E CONTRACTOR.

29. This permit does not constitute a well permit. The depth of the well and type of well construction will be determined by the Water Supply Branch (302/736-3665). The location of the well must be 100 feet from the on-site system when possible but not less than 50 feet.

30. A satisfactory Certificate of Completion must be issued by the Department for this system prior to its use. This permit is not valid for operation and maintenance until the required Certificate has been issued.

31. WARNING! - Regarding Elevated Sand Mound (ESM) systems. Wet conditions during the period of December 1 thru May 15 may preclude the installation of the system approved by this permit. Please contact the Department to inquire the status of soil moisture conditions prior to installation.

32. WARNING! - Regarding Low Pressure Pipe (LPP) systems. Wet conditions may preclude the installation of the system approved by this permit. Please contact the Department to inquire the status of soil moisture conditions prior to installation. A site check of the approved soils area will be conducted by the Department.

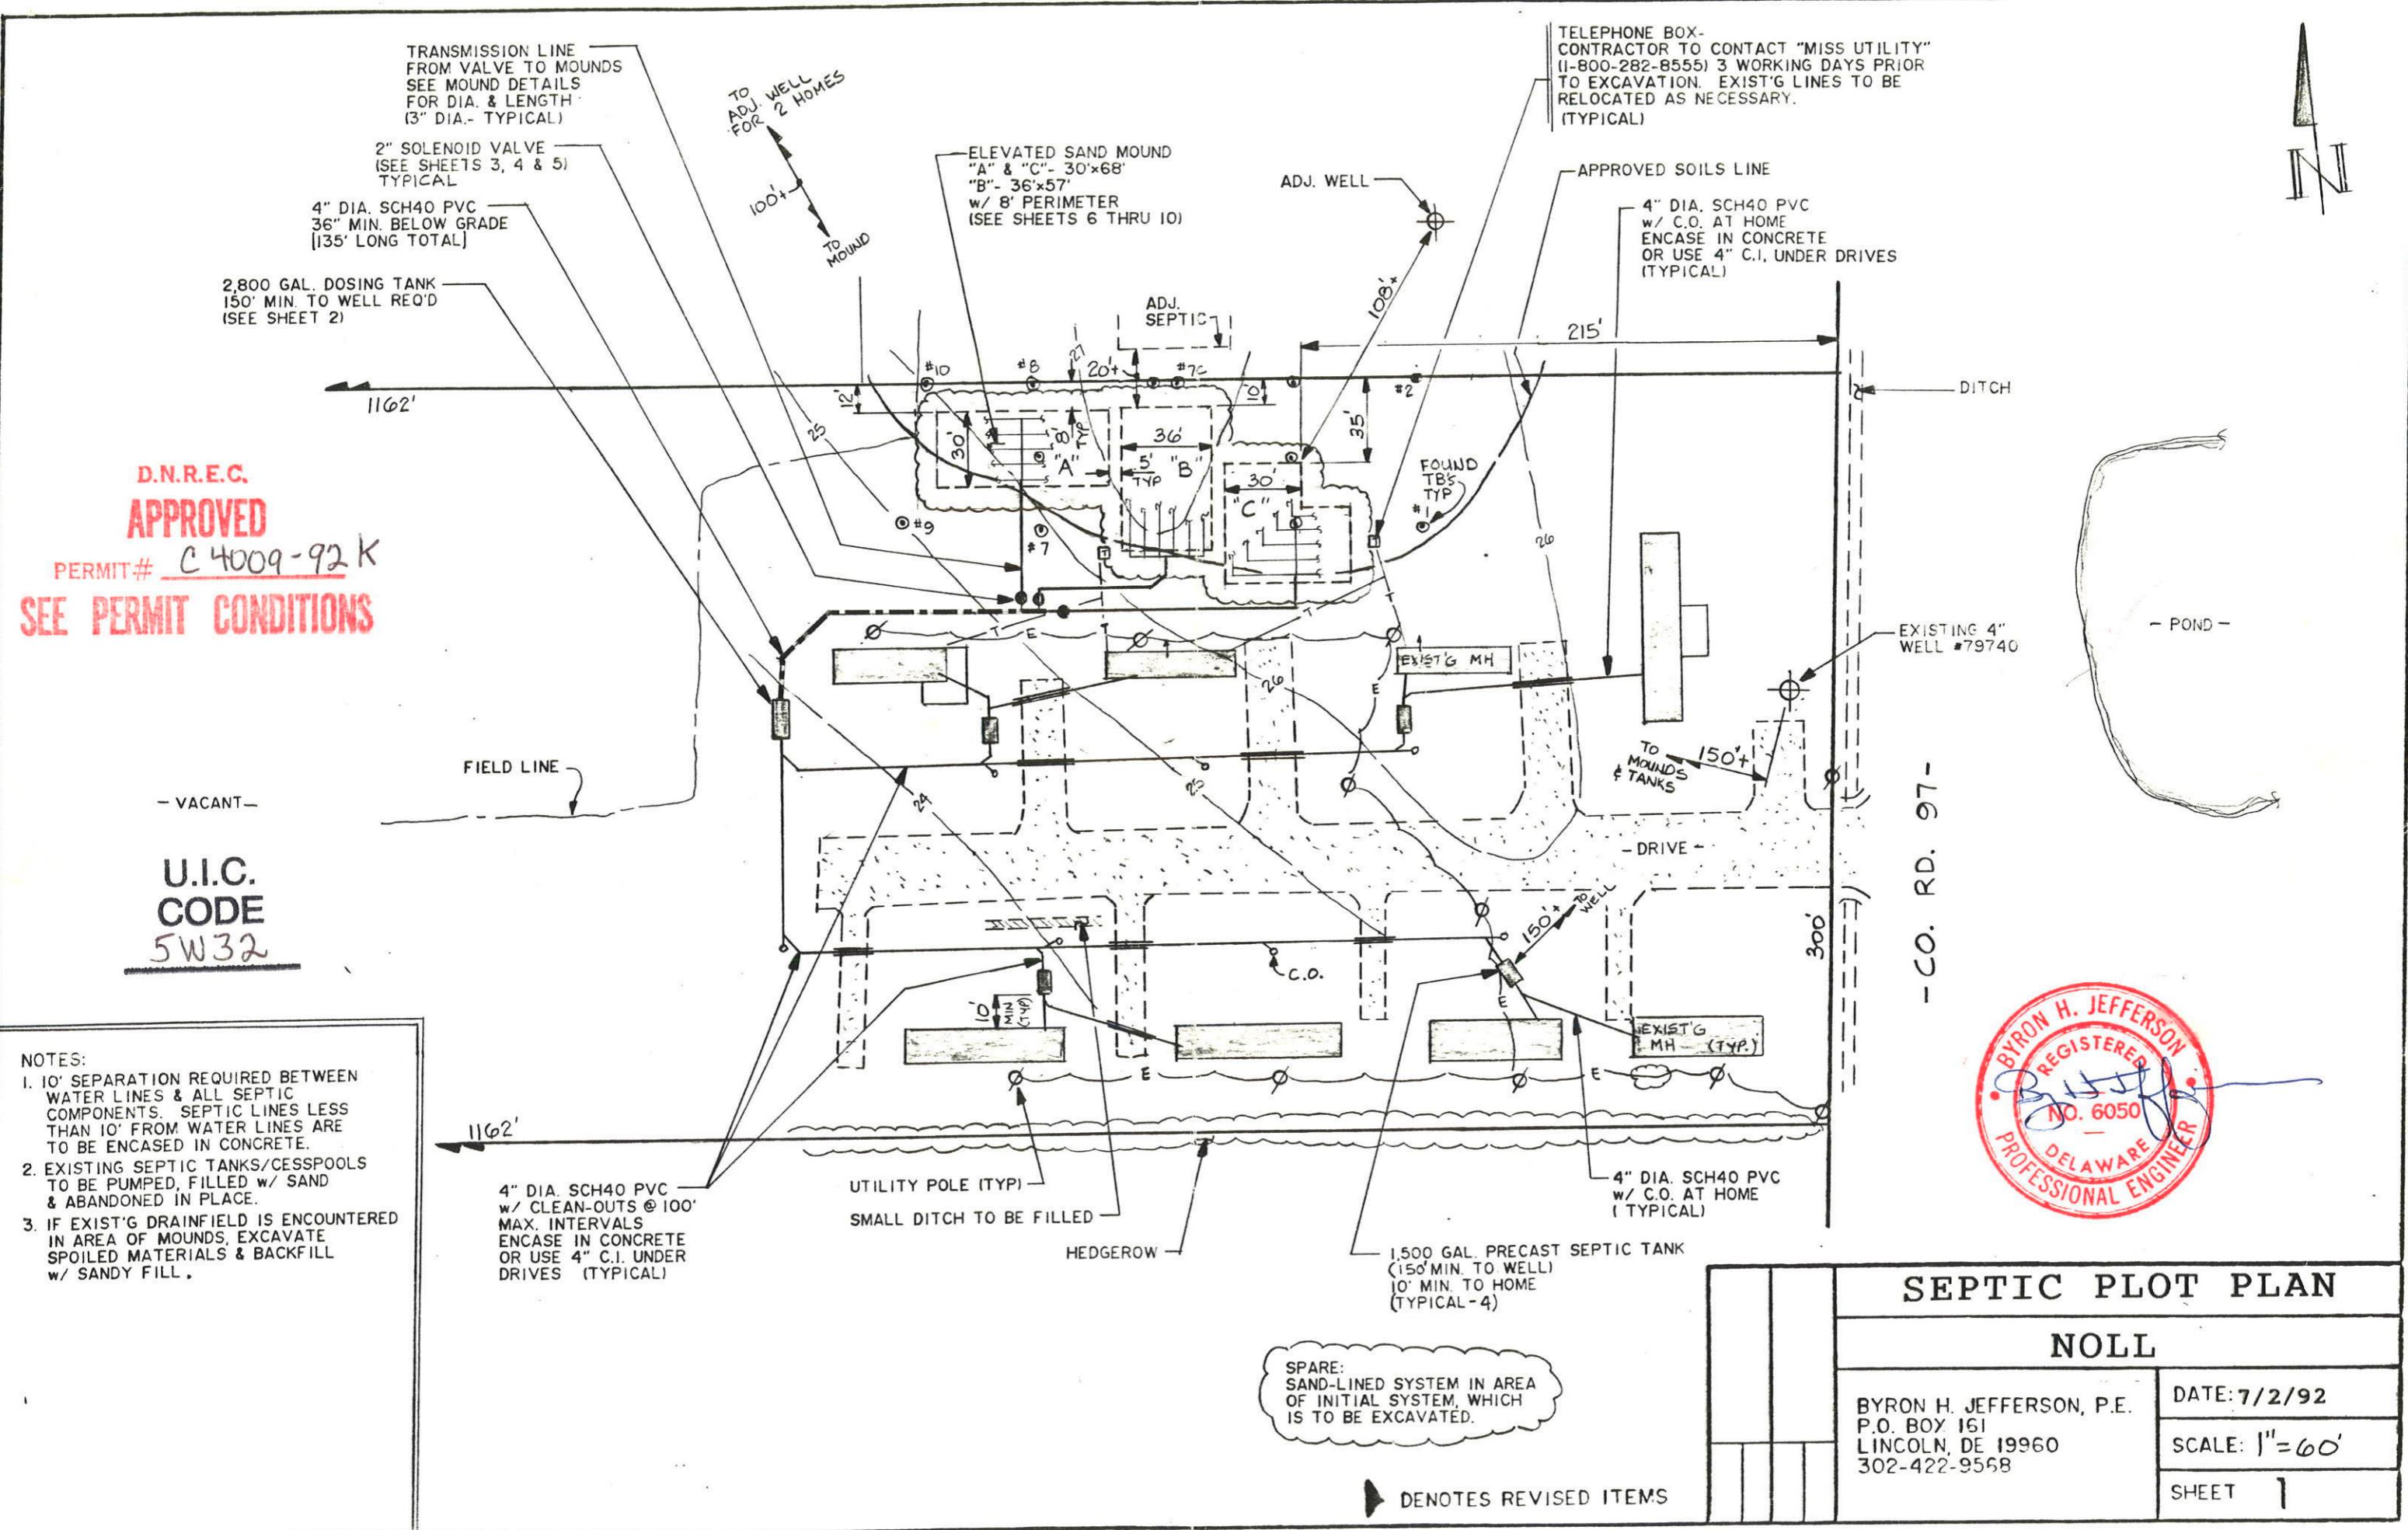

NOTES:

1. All electrical connections inside tank to be explosion-proof, corrosion resistant, and waterproof.
2. Contact engineer for check-out of system installation & operation PRIOR to placing dosing chamber in operation.
3. Engineer to submit as-builts with inspection report to DNREC.
4. EQUIPMENT:

Float switches: Mercury tube type sealed in polyurethane float ball. Circuit: lamp max. Control box: NEMA-3R for outside mount or NEMA-1 inside. Use control box of same manufacturer as pump.


Alarm (high-level): Use alarm integral with control or separate, but alarm to operate on 115 volt AC and separate circuit from pumps. Use NEMA-3R for outside, NEMA-1 for inside. Alarm to show both red-lit & bell or buzzer.

PUMP: Goulds Model 3887 or equal (1 HP, 230 Volt AC, 1Ø, 3887 gpm at ft., submersible sewage)

DOSING TANK DETAILS

FOR
NOLL


BYRON H. JEFFERSON
P.O. BOX 161
LINCOLN, DE 19960
DATE 7/2/92
SCALE: N.T.S.
SHEET 2

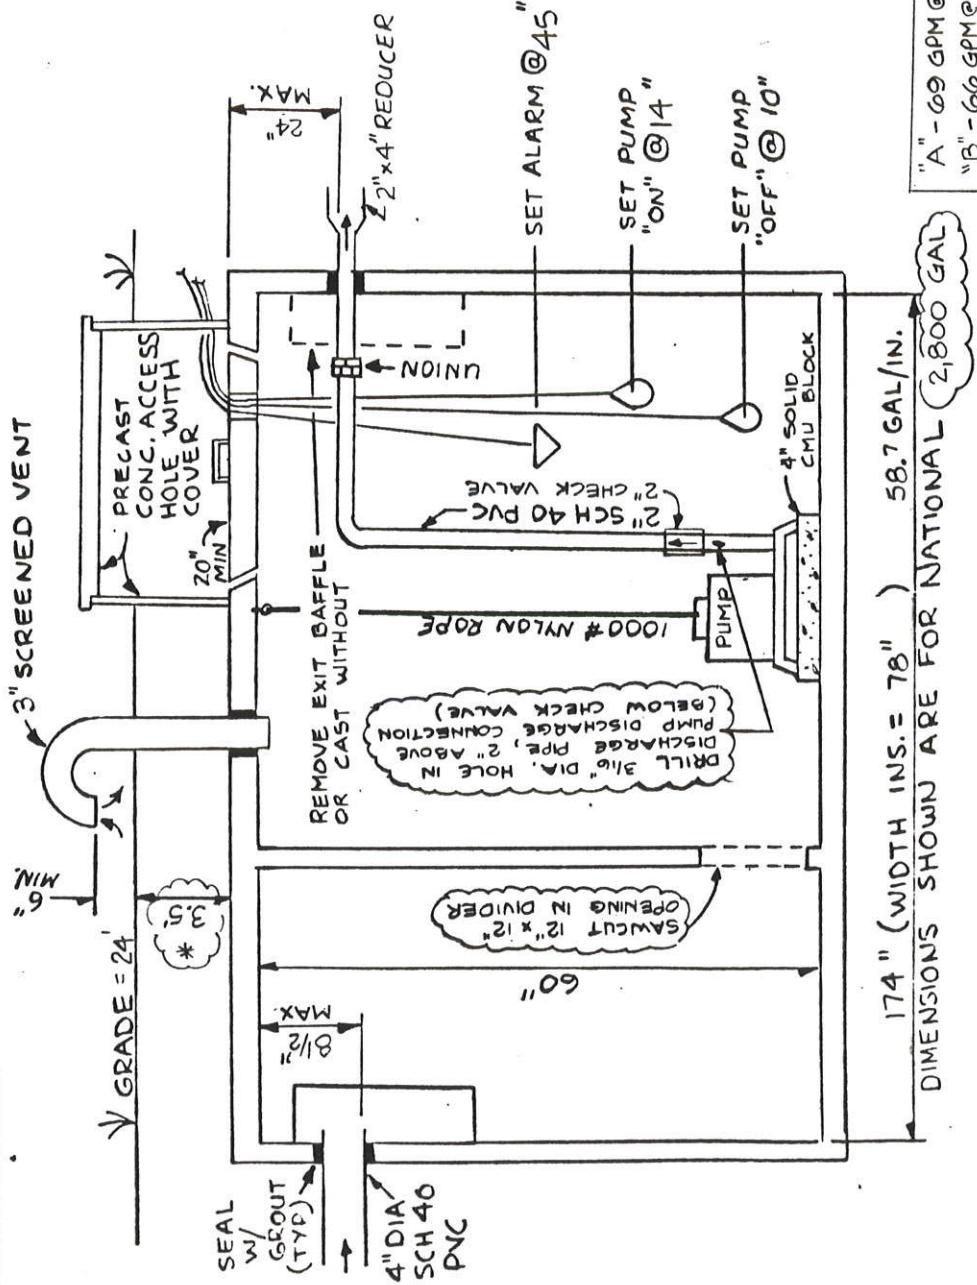

EFFECTIVE DOSE
PER CYCLE = 235 GAL



■ DENOTES REVISED ITEMS

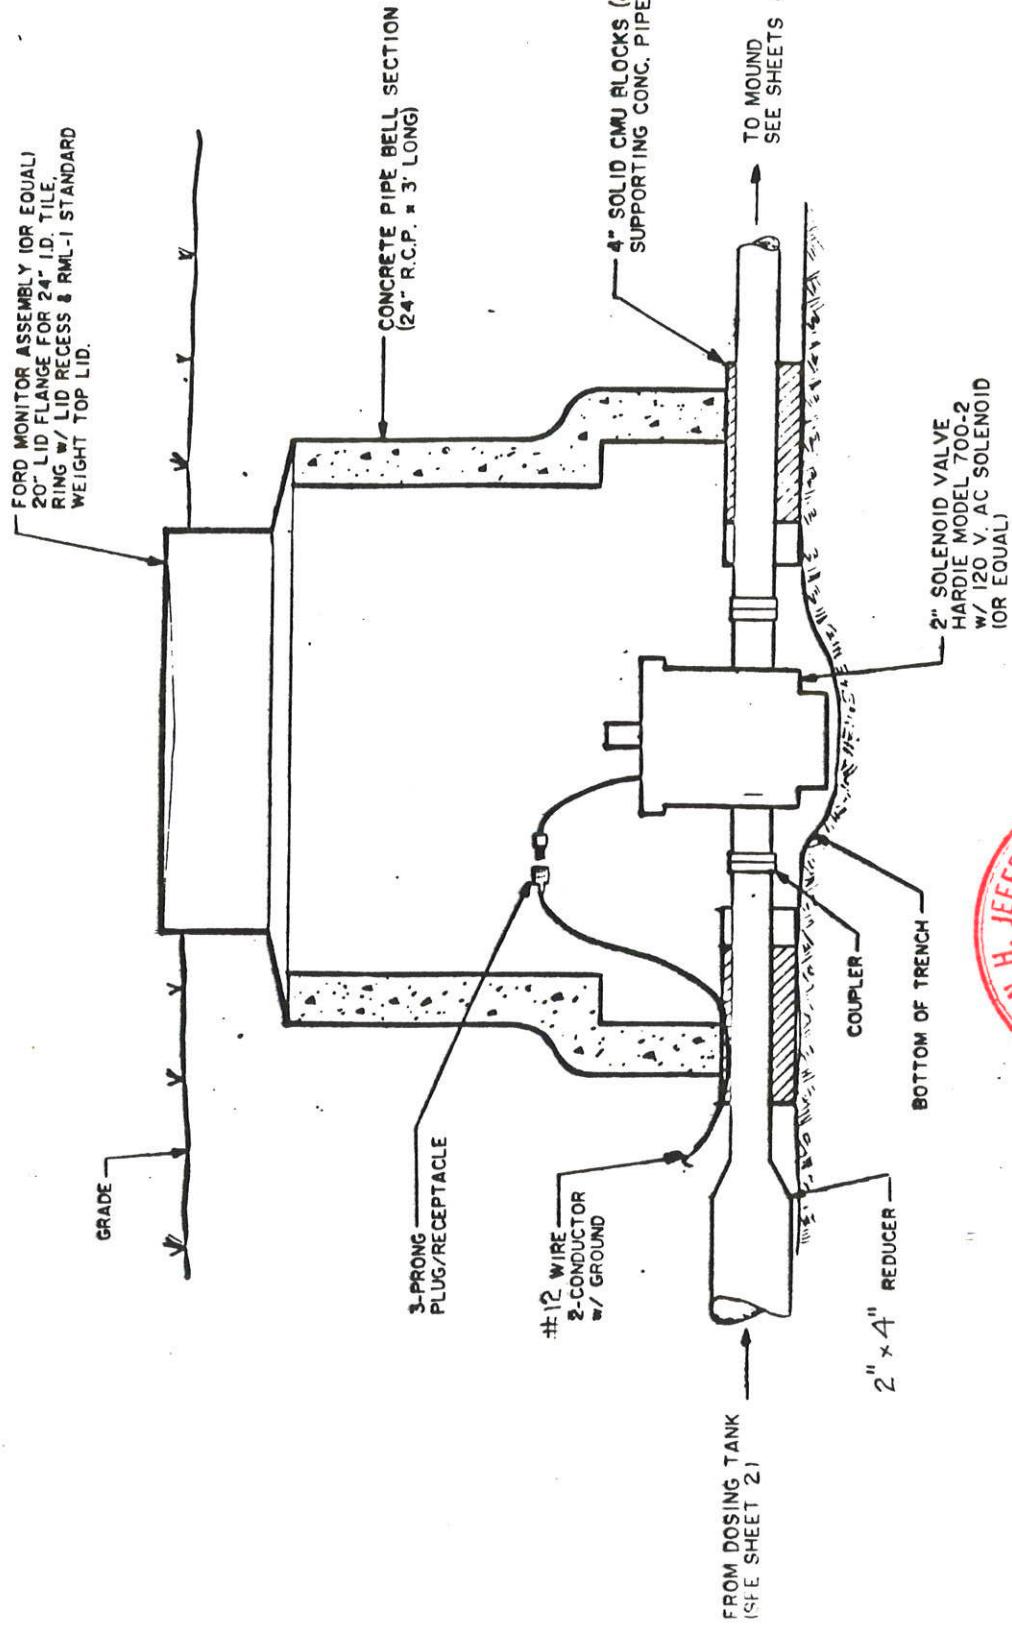

SOLENOID VALVE DET'L
NOLI


1

BYRON H. JEFFFRSON, P.E.
P.O. BOX 161
LINCOLN, DE 19960
302-422-9558

DATE: 7/2/92
SCALE: NTS
SHEET 5




DENOTES REVISED ITEMS

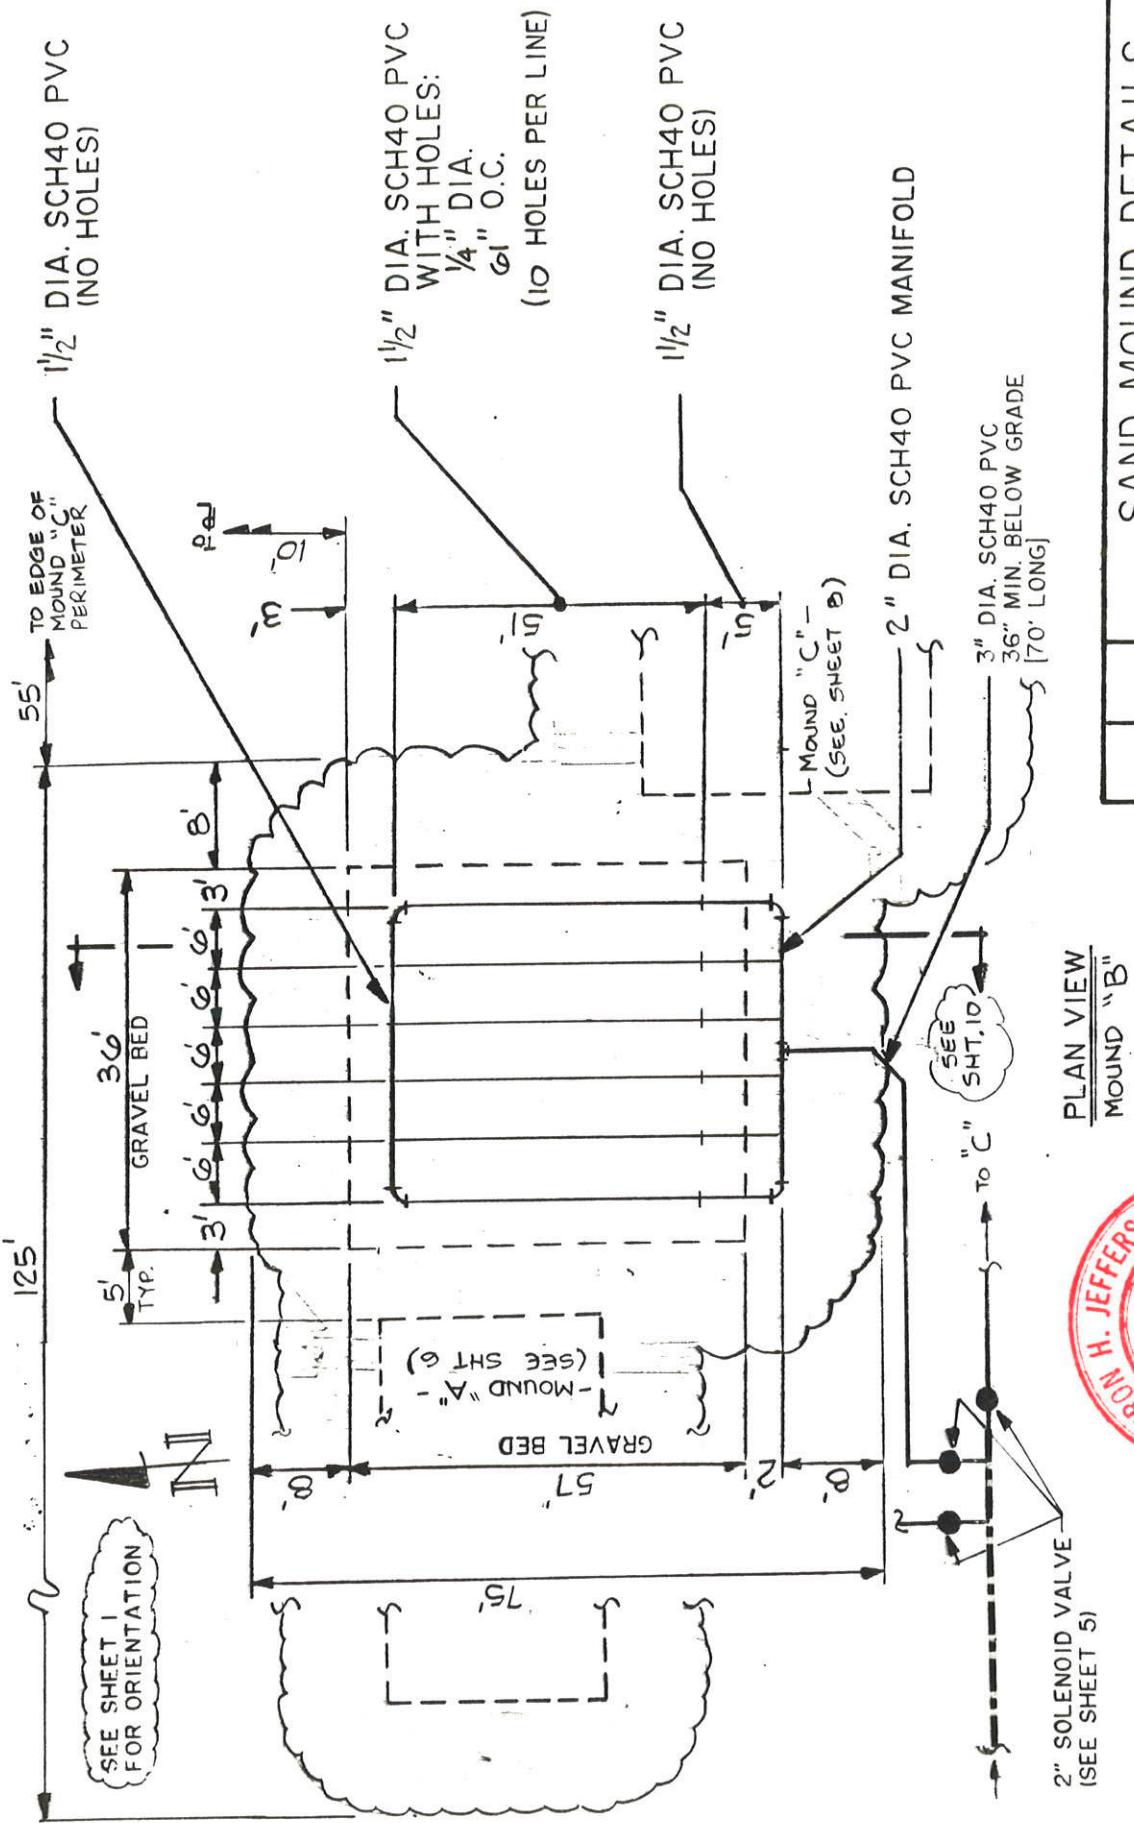

DENOTES REVISED ITEMS

Page 12 of 22 Pages

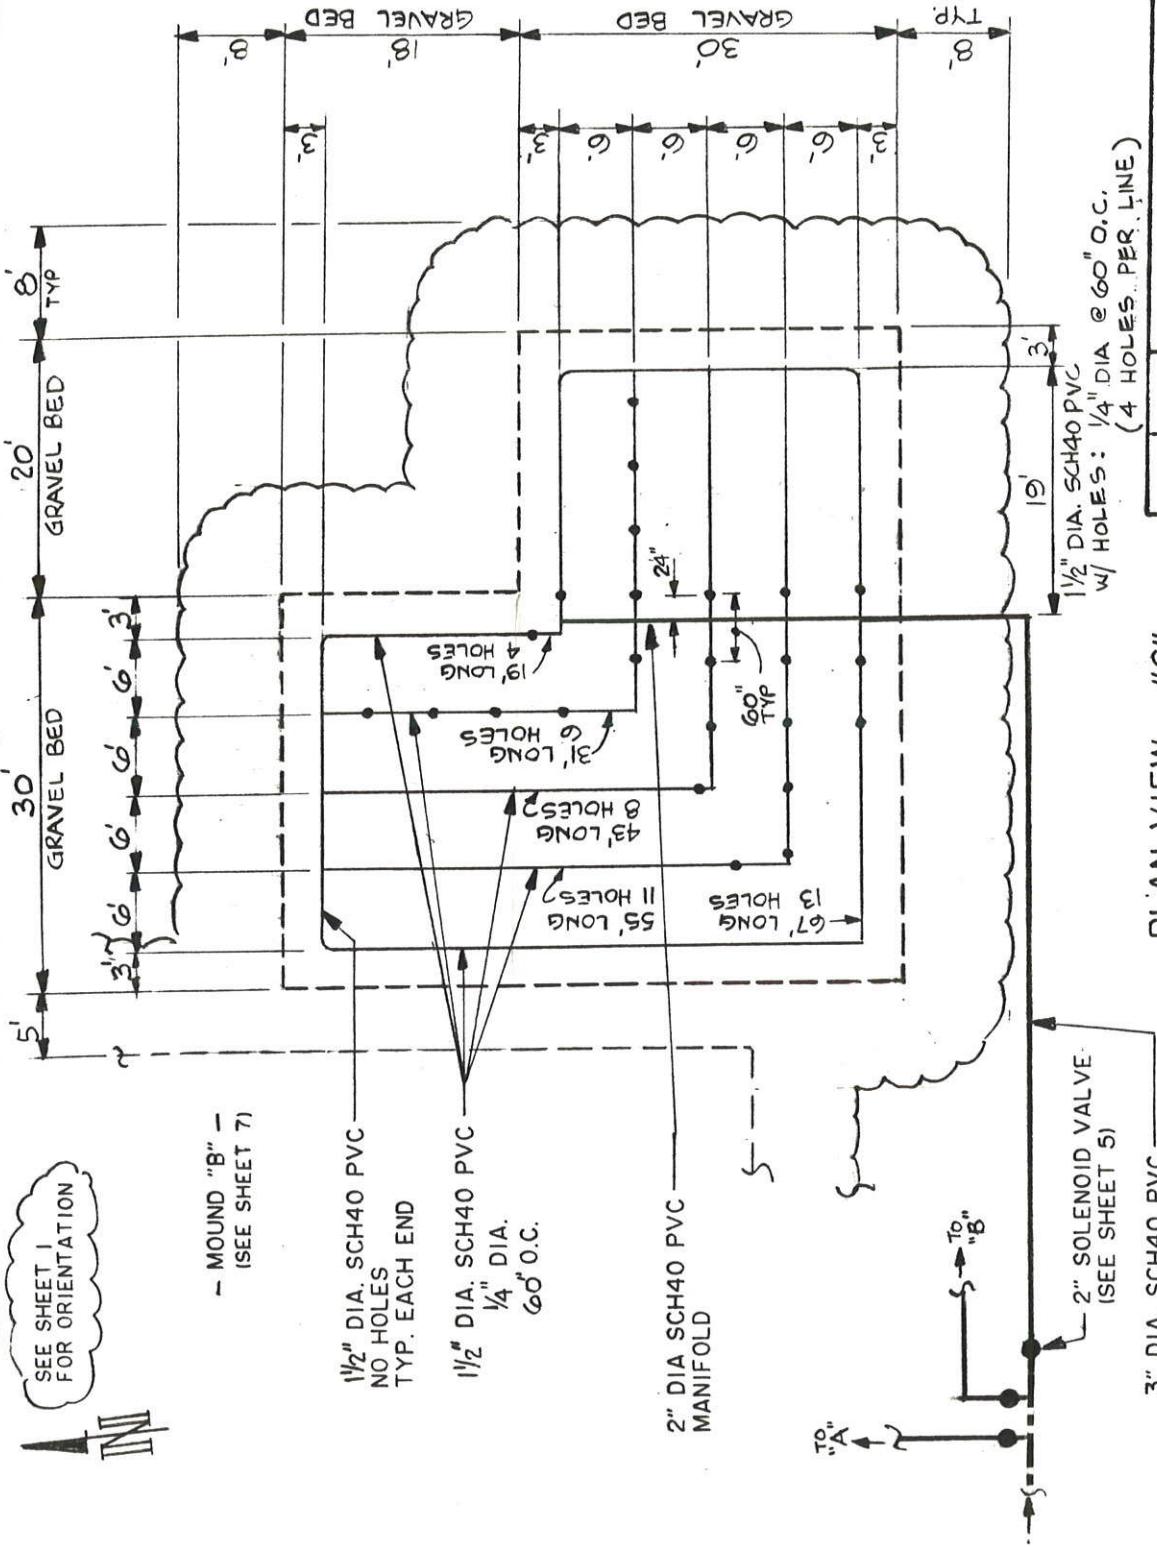

SAND MOUND DETAILS

NOTE


BYRON H. JEFFERSON, P.E.
P.O. BOX 161
LINCOLN, DE 19960
302-422-9568

DATE: 7/2/92

SCALE: NTS

SHEET 8

DENOTES REVISED ITEMS

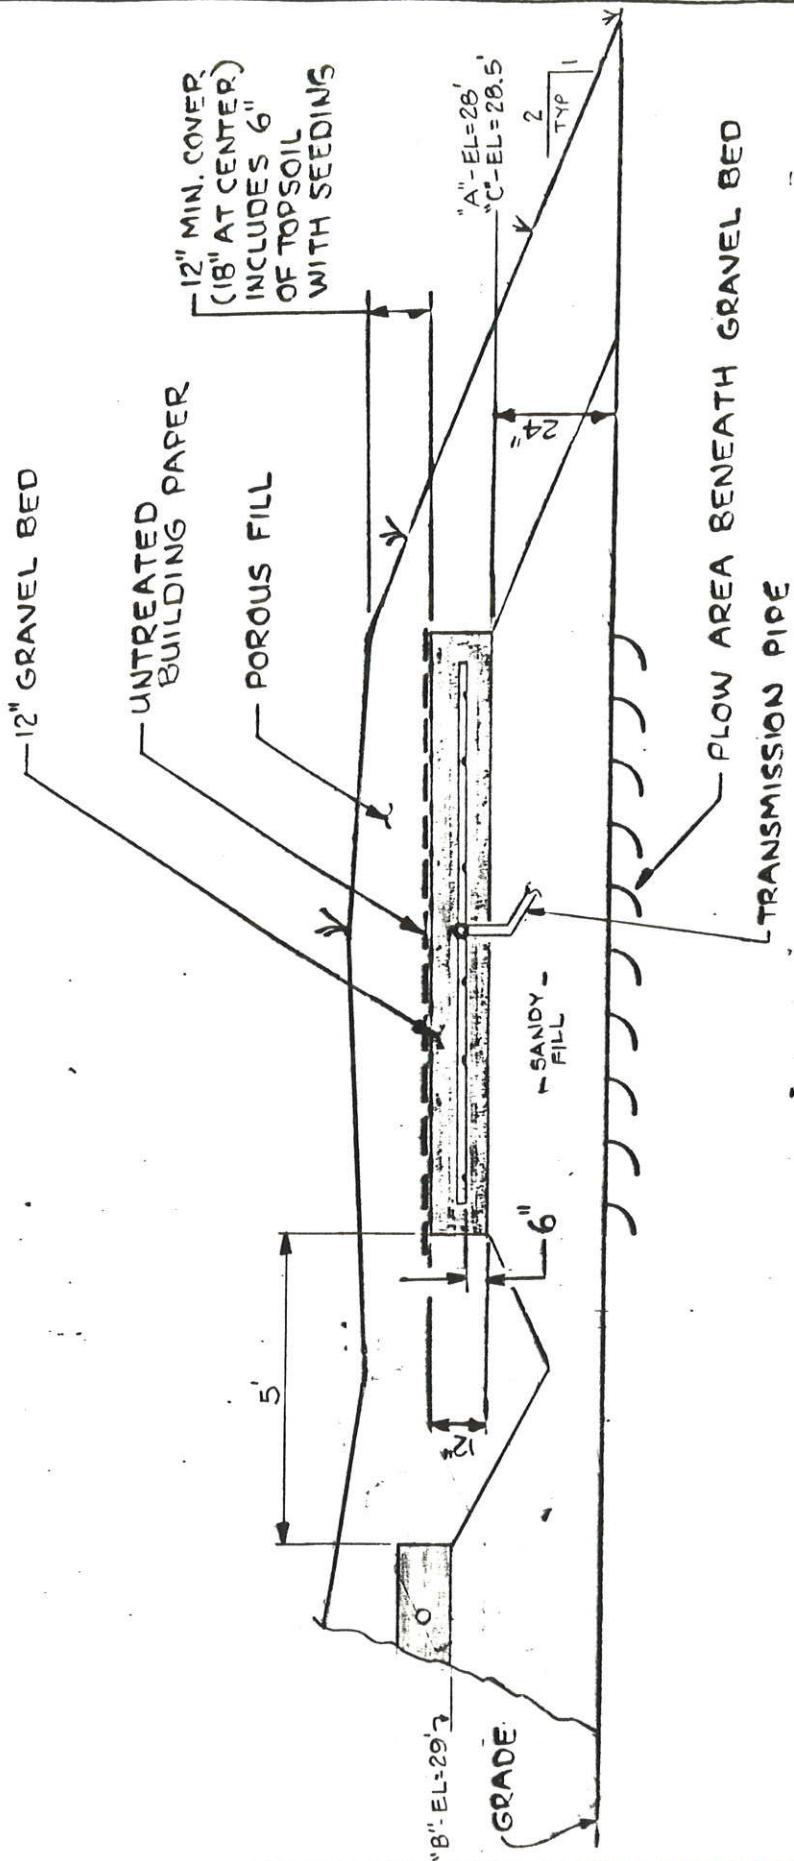


ELEVATION VIEW (SECTION) - MOUNDS "A" & "C"

SAND MOUND DETAILS
NOLL

BYRON H. JEFFERSON	DATE 7/2/92
P.O. BOX 161	SCALENTS
LINCOLN, DE 19960	SHEET 9



► DENOTES REVISED ITEMS

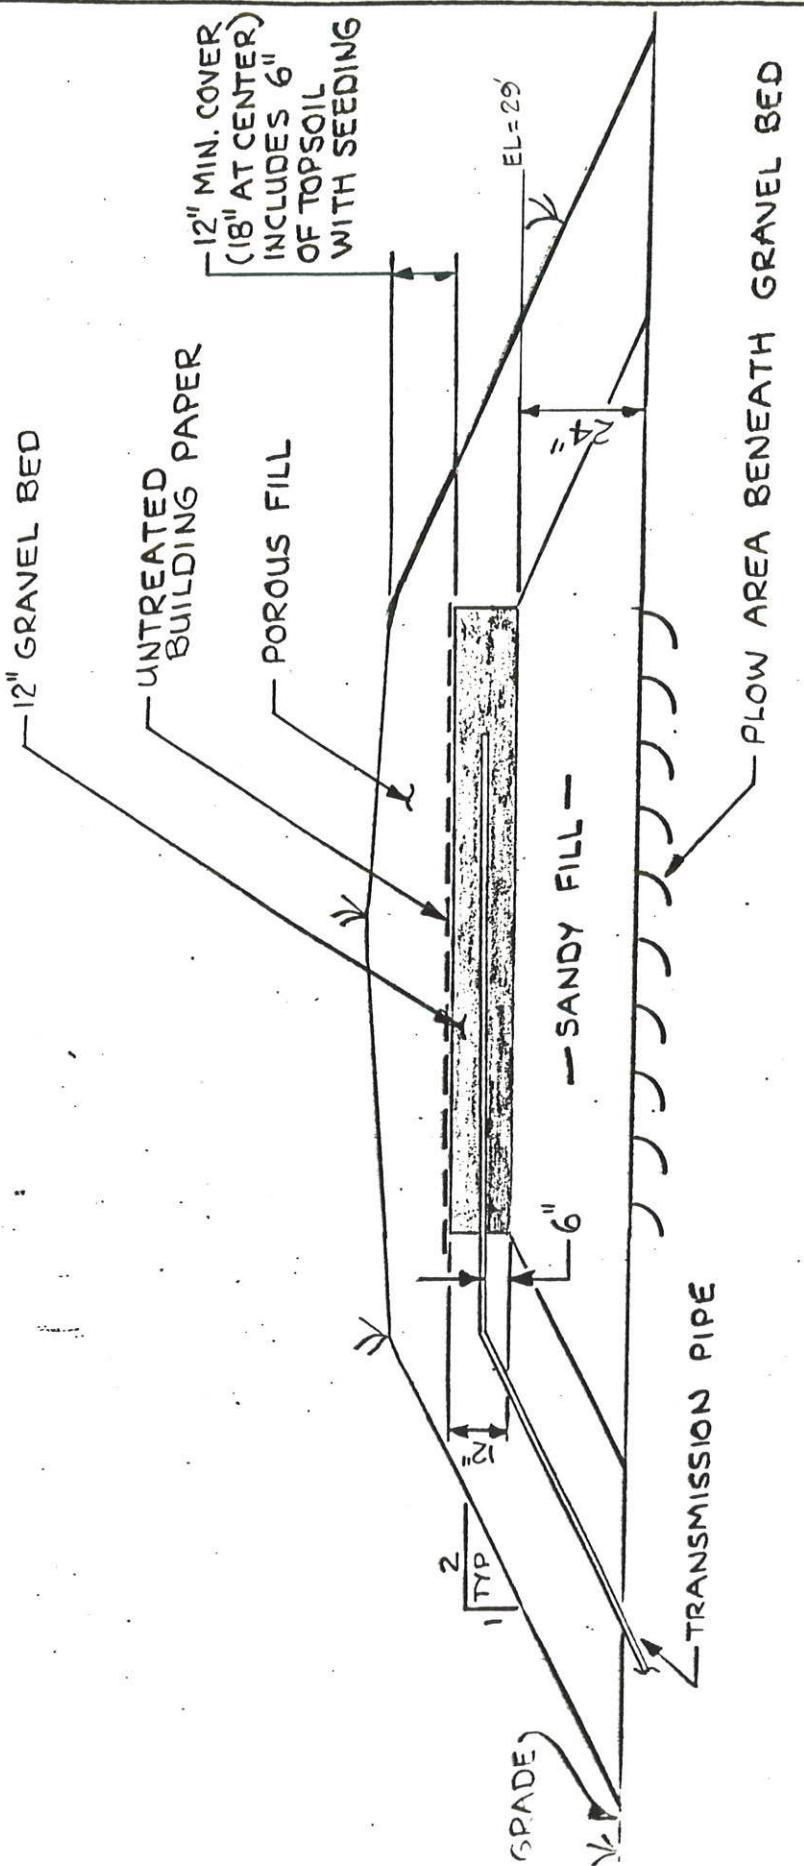

ELEVATION VIEW (SECTION) - MOUND "B"

SAND MOUND DETAILS		DATE 7/2/92	SCALE: NTS	SHEET 10
NO. 1	NO. 2			
BYRON H. JEFFERSON P.O. BOX 161 LINCOLN, DE 19960				

► DENOTES REVISED ITEMS




Performance Curve

MODEL

3887

Submersible Sewage Pumps

METERS FEET

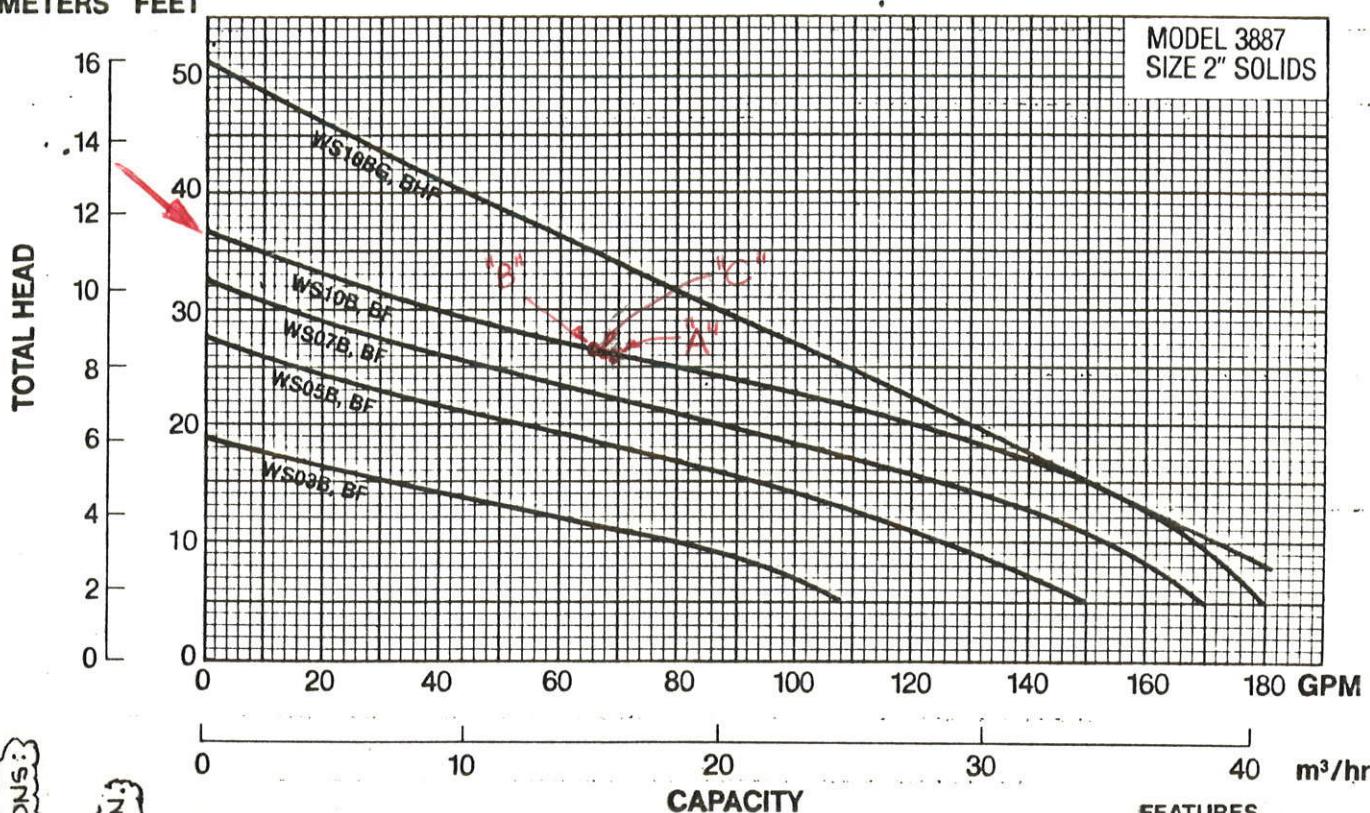

SPECIFICATIONS

Pump:

Solids Handling Capabilities: 2" maximum
Capacities: Up to 180 GPM
Total Heads: Up to 49 feet TDH
Discharge types available:
2" NPT threaded casing.
2" NPT threaded companion flange — "BF" or "BHF" units.
Optional 3" NPT threaded companion flange — "BF" or "BHF" units, must order (A1-3) companion flange separately.
Mechanical Seal: Carbon rotary/ceramic stationary, 300 series stainless steel metal parts, BUNA-N elastomers.
Temperature: 160°F (71°C) maximum.
Fasteners: 300 series stainless steel.
Capable of running dry without damage to components.

Motor:

Single Phase: 1/3-1/2 HP 115V or 230V, 60 Hz, 1750 RPM; 3/4-1 HP 230V, 60 Hz, 1750 RPM; 1 HP, 230V, 60 Hz, 3500 RPM. Built in overload with automatic reset.
Three Phase: 1/2-1 HP 208/230-460V, 60 Hz, 1750 RPM; 1 HP 208/230-460V, 60 Hz, 3500 RPM. Overload protection must be provided in starter unit.
Shaft Threaded 400 series stainless steel.
Bearings: Ball bearings — upper and lower.
Power Cord: 15' standard (optional lengths available).
Single Phase: 1/3-1/2 HP, 16/3 SJTO with three prong plug; 3/4 and 1 HP, 14/3 STO with bare leads.
Three Phase: 1/2-1 HP 14/4 STO with bare leads.
On CSA listed models: 20' length SJTW or STW are standard.

FEATURES

Impeller: Cast iron — semi-open, non-clog with pump-out vanes for mechanical seal protection. Balanced for smooth operation.

Casing: Cast iron volute type for maximum efficiency. 2" NPT discharge adaptable for slide rail systems.

Mechanical Seal: Ceramic vs carbon sealing faces, stainless steel metal parts, Buna N elastomers.

Shaft: Corrosion resistant stainless steel. Threaded design. Locknut on three phase models to guard against component damage on accidental reverse rotation.

Motor: Fully submerged in high grade turbine oil for lubrication and efficient heat transfer. Designed for continuous operation. All ratings are within the working limits of the motor.

Bearings: Upper and lower heavy duty ball bearings construction.

Power Cable: Severe duty rated, oil and water resistant. Epoxy seal on motor-end provides secondary moisture barrier in case of outer jacket damage and to prevent oil wicking.

O-Ring: Assures positive sealing against contaminants and oil leakage.

TANK ALERT® II PLUS

ALARM SYSTEM/PUMP CONTROL

An economical, quality indoor or outdoor liquid level alarm system/pump control.



ADVANTAGES

- * Controls your pump and warns of high or low liquid level.
- * If pump should fail, pulsating horn and flashing red light are activated by a reliable alarm float.
- * The pump float assures of correct pump on-off level.
- * Mounting straps for both alarm float and pump float included with unit.
- * Both alarm float and pump float come standard with twenty feet of cable.
- * HOA switch allows for Hand (manual), Off, or Automatic pump operation.
- * Alarm on/off switch controls power to the float circuitry. This and the pump HOA switch provide an additional safety feature when servicing.
- * Green pump run light.
- * Horn silence switch has automatic reset feature.
- * Push-to-test switch assures of proper horn and light alarm operation.
- * NEMA 4X non-metallic enclosure—exposed parts are corrosion, wind and rain resistant.
- * Simple terminal strip and wiring diagram also provides for Double Float pump switch installation. (Double Float pump switch may be substituted for Super Single pump switch at a nominal extra cost. See page 4.)
- * ENTIRE UNIT UL Listed and CSA Certified.
- * Two-year limited warranty.

APPLICATION

A single control panel, plus two easily installed floats, provides residential and commercial customers with a reliable means of controlling simplex (one pump) systems in a water or sewage installation. Common applications include pump chambers, sump pump basins, irrigation systems, etc.

ALARM ON/OFF SWITCH

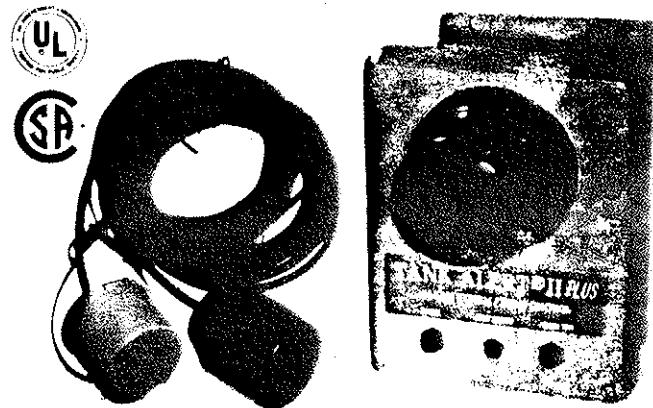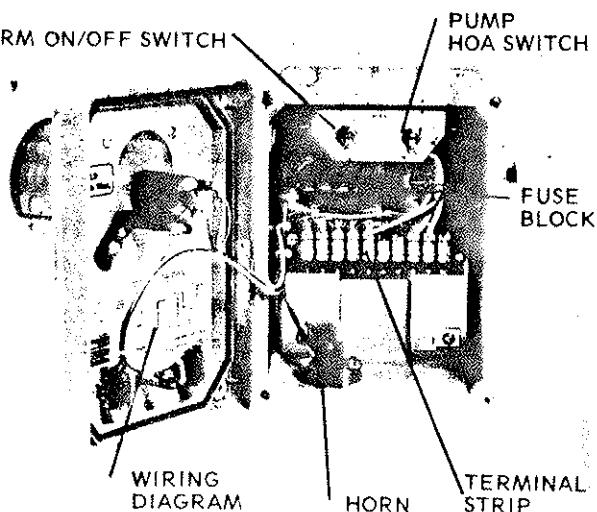

DESCRIPTION

The Tank Alert® II Plus consists of a control panel, a pump float, and an alarm float.


CONTROL PANEL EXTERIOR: The non-corrosive, indoor and/or outdoor enclosure comes preassembled. The green pump run light, silence switch (with automatic reset feature), and alarm test switch are conveniently accessible on the front of the panel.


CONTROL PANEL INTERIOR: The interior alarm system consists of a high-quality alarm relay, a solid-state flasher, a weather-proof horn, and a standard light bulb that are all fuse protected.

A handy HOA switch allows for either Hand (manual), Off, or Automatic pump operation. A second switch is provided as an on/off for control panel alarm system. These switches are located inside the panel to protect against activation by unauthorized personnel.

PUMP FLOAT: SJE's Super Single pump switch model 20SS WOP.

ALARM FLOAT: SJE's Sensor Float model 20PC. A terminal strip with easy-to-follow wiring diagram provides for simple installation of both alarm and pump floats.

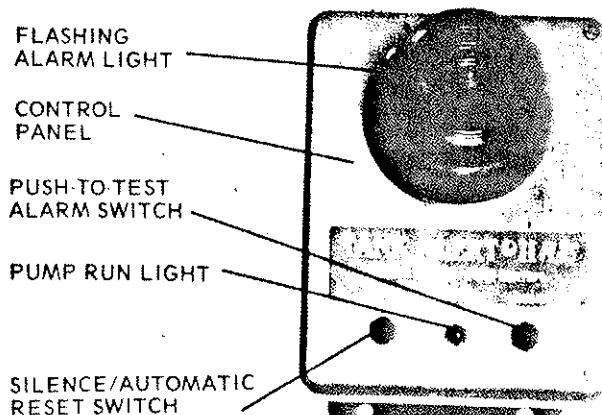

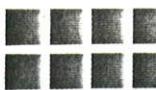

Easy to use electronic controls for lighting,
HVAC, security and in-plant equipment.


EZ CONTROLS®

Multi-Channel Electronic Time Switches

- For Line Voltage Applications
- 7 Day Plus 365 Holiday Scheduling
- Heavy Duty 20AMP/240V Contacts
- Daylight Savings Time Adjustment
- 4 and 8 Channels
- Holiday Programming
- Duty Cycling
- Lockable Case

EZ-734HD

EZ-738HD

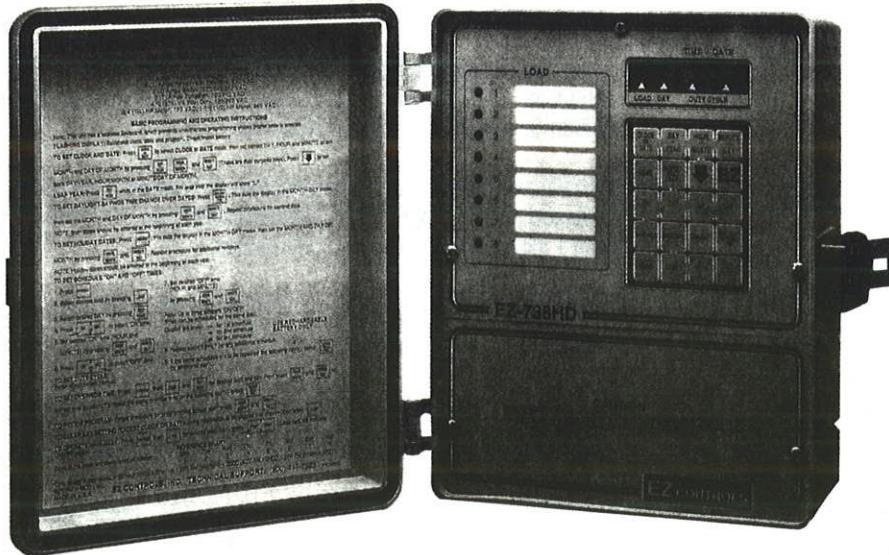

DESCRIPTION:

Designed for line voltage applications to control lighting, heating, ventilating, air conditioning, security and other loads in small and medium size buildings.

With flexible 365 day scheduling, battery backup, 10 year memory retention and 20AMP/240V contacts, it reduces energy consumption by operating equipment more efficiently, inexpensively, and with simple operation, without sacrificing comfort or convenience.

Extremely easy to install and operate, they are the ideal alternative to mechanical time clocks or energy management systems, at a fraction of the cost.

FEATURES AND BENEFITS:


- Extremely easy to operate and understand.
- 20AMP/240V heavy duty switch contacts, NO and NC.
- Rechargeable battery back-up, eliminates resetting.
- 10 year memory retention. No reprogramming required.
- Fully independent 7 day plus 365 day scheduling, up to 3 ON and OFF operations per channel per day.
- 20 holidays programmable up to a year in advance.
- Programmable Daylight Savings Time adjustment.
- Duty cycling, up to 3 patterns per channel per day.
- Programmable timed override, for manual operation.
- Automatic 4 second load staggering.
- Outdoor lockable case, NEMA type 3R
- Low cost, ideal alternative to mechanical time clocks or energy management systems.

USES AND APPLICATIONS:

- Offices
- Hospitals
- Factories
- Schools
- Banks
- Fast food restaurants
- Retail stores
- Libraries
- Grocery Stores
- Car dealerships

CRAFTED WITH PRIDE IN THE U.S.A.

*The UltraFlow family includes sizes from 1" all the way up to 2".
Whatever your flow requirements, we have a valve
to handle it.*

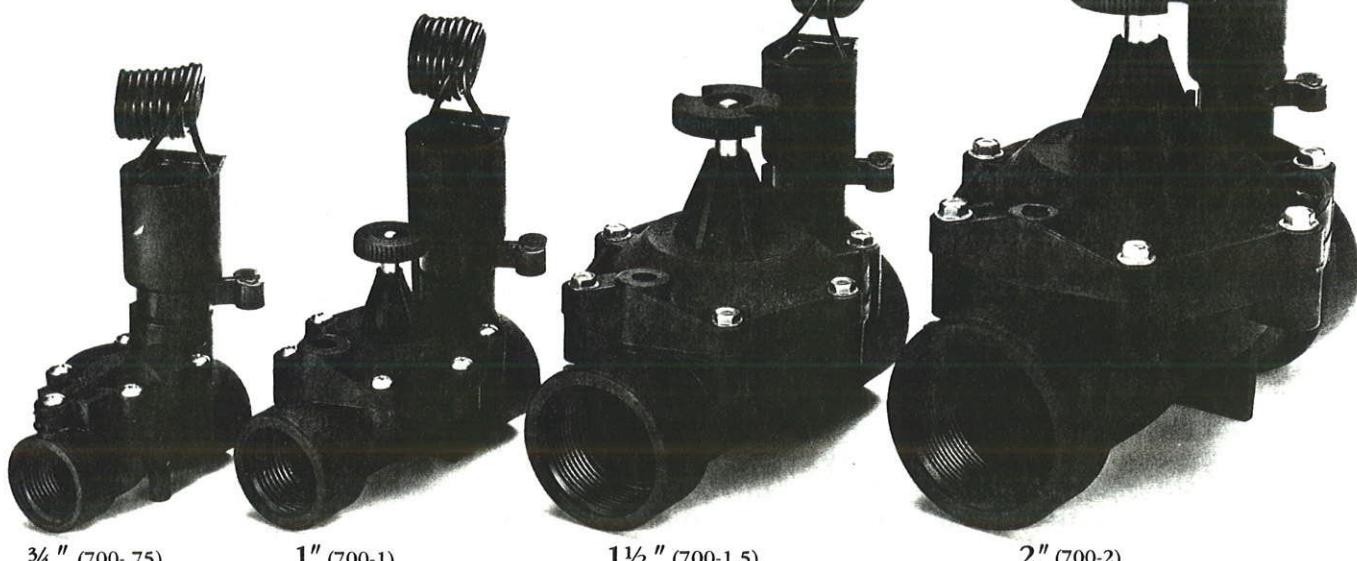

3/4 " (700-75)

1" (700-1)

1 1/2 " (700-1.5)

2" (700-2)

proof rubber encased pressure gauge.



Western Region
1588 N. Marshall
El Cajon, CA 92020
(619) 562-2950
FAX (619) 258-9973

Central Region
228 North Interurban
Richardson, TX 75081
(214) 783-1683
FAX (214) 690-5855

Eastern Region
3000 Mellonville Ave. Bldg. 422
Sanford, FL 32771
(407) 321-2900
FAX (407) 322-8104

International
1588 N. Marshall
El Cajon, CA 92020
(619) 562-2950
FAX (619) 258-7960
Telex 3719648

P/N HHA 10986 1-90