
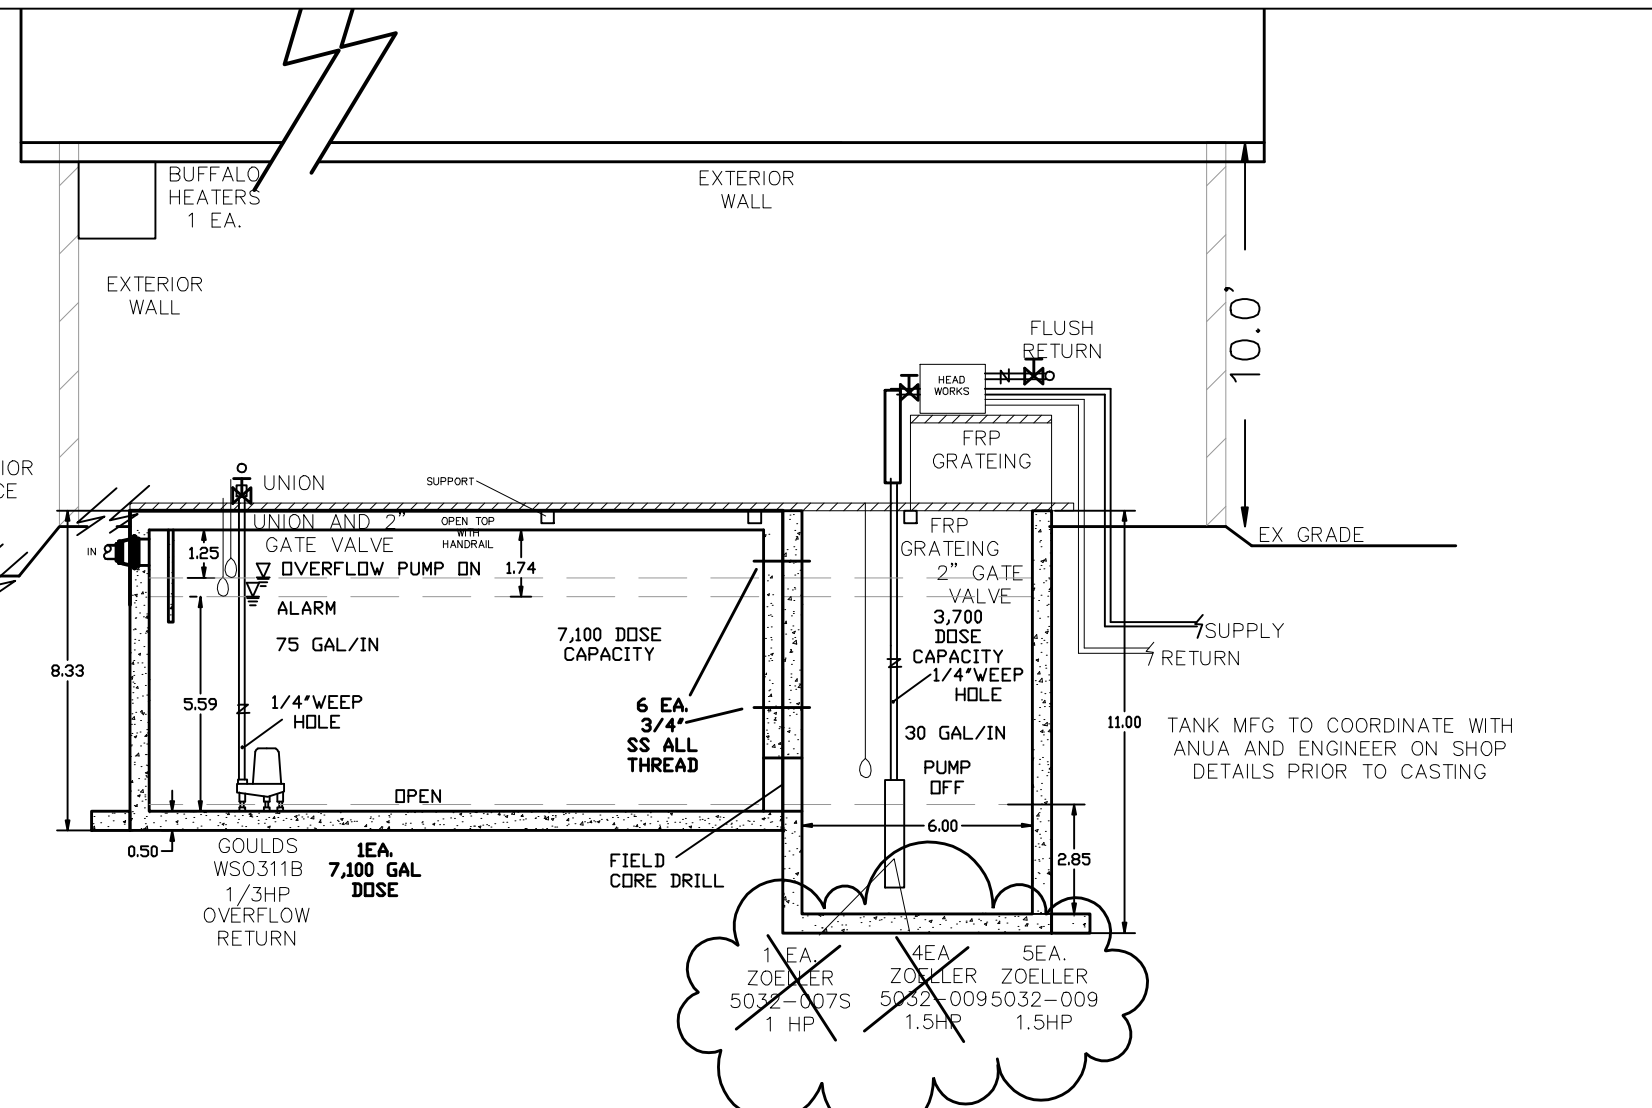
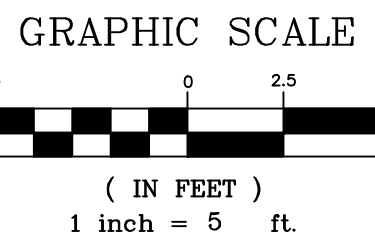
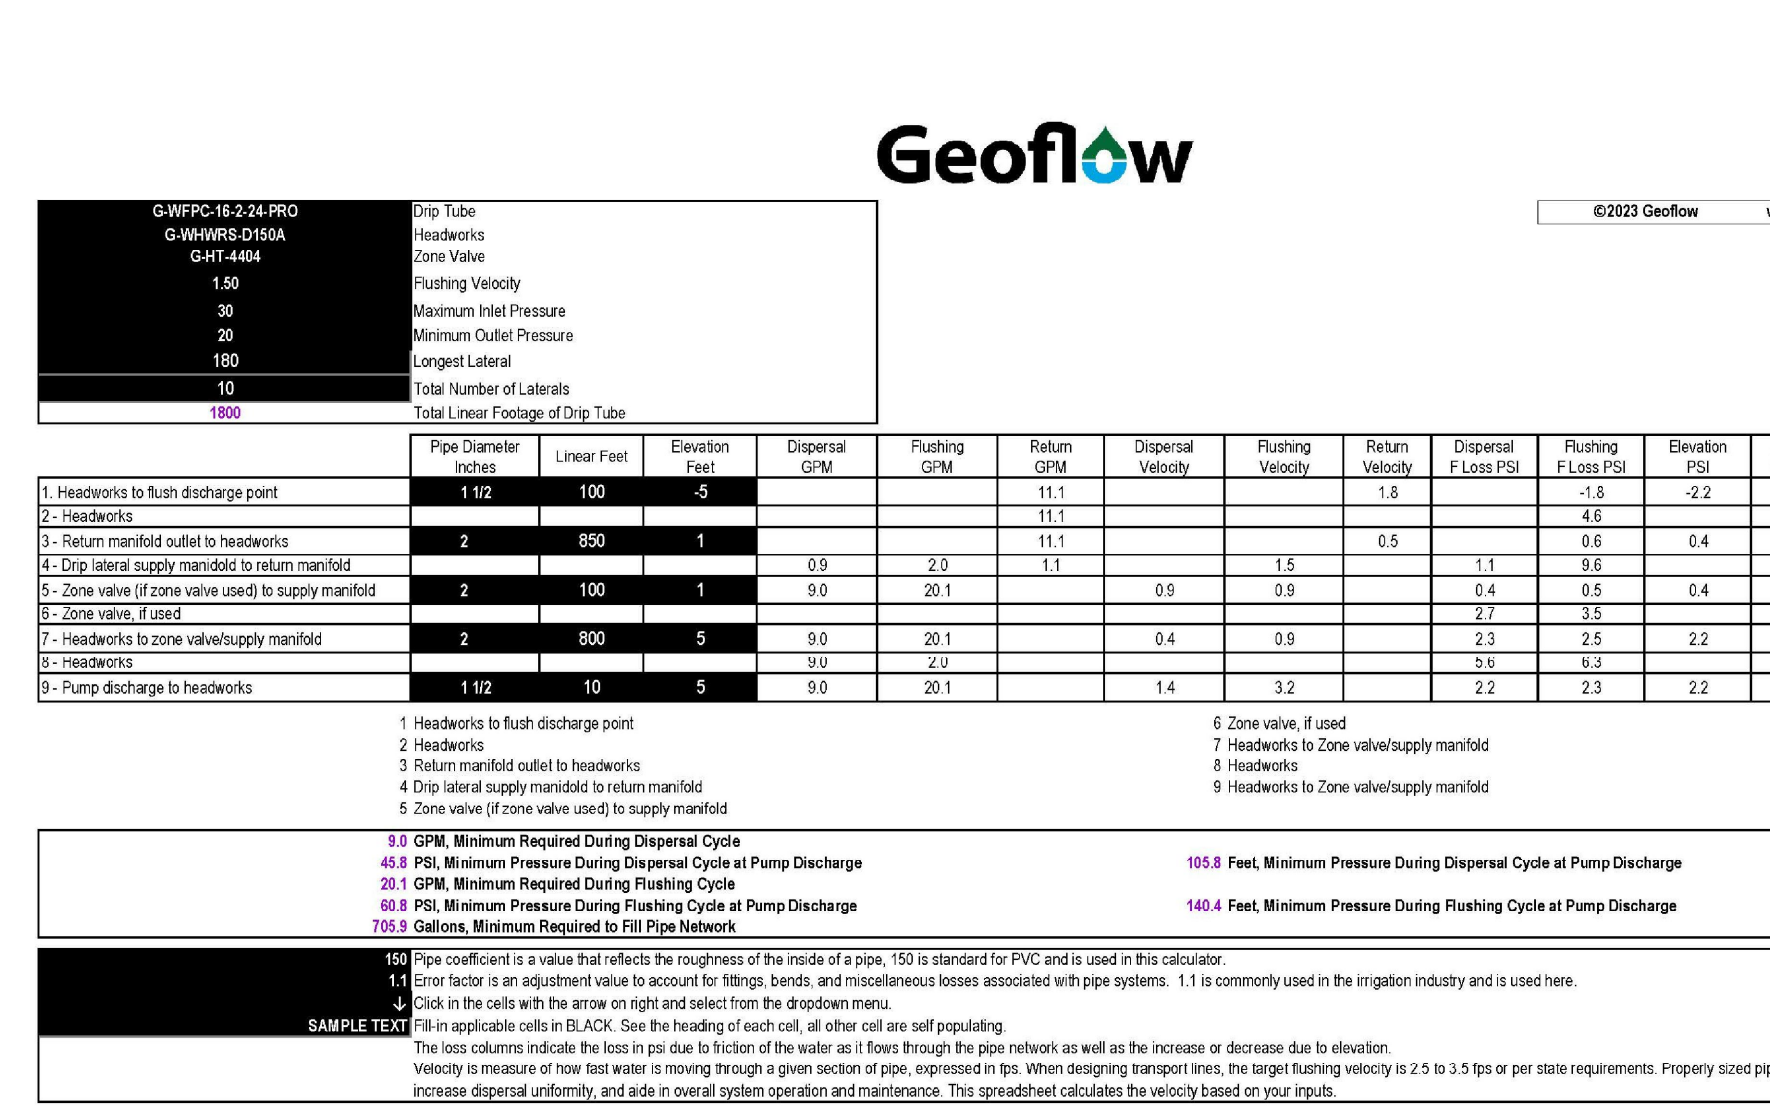
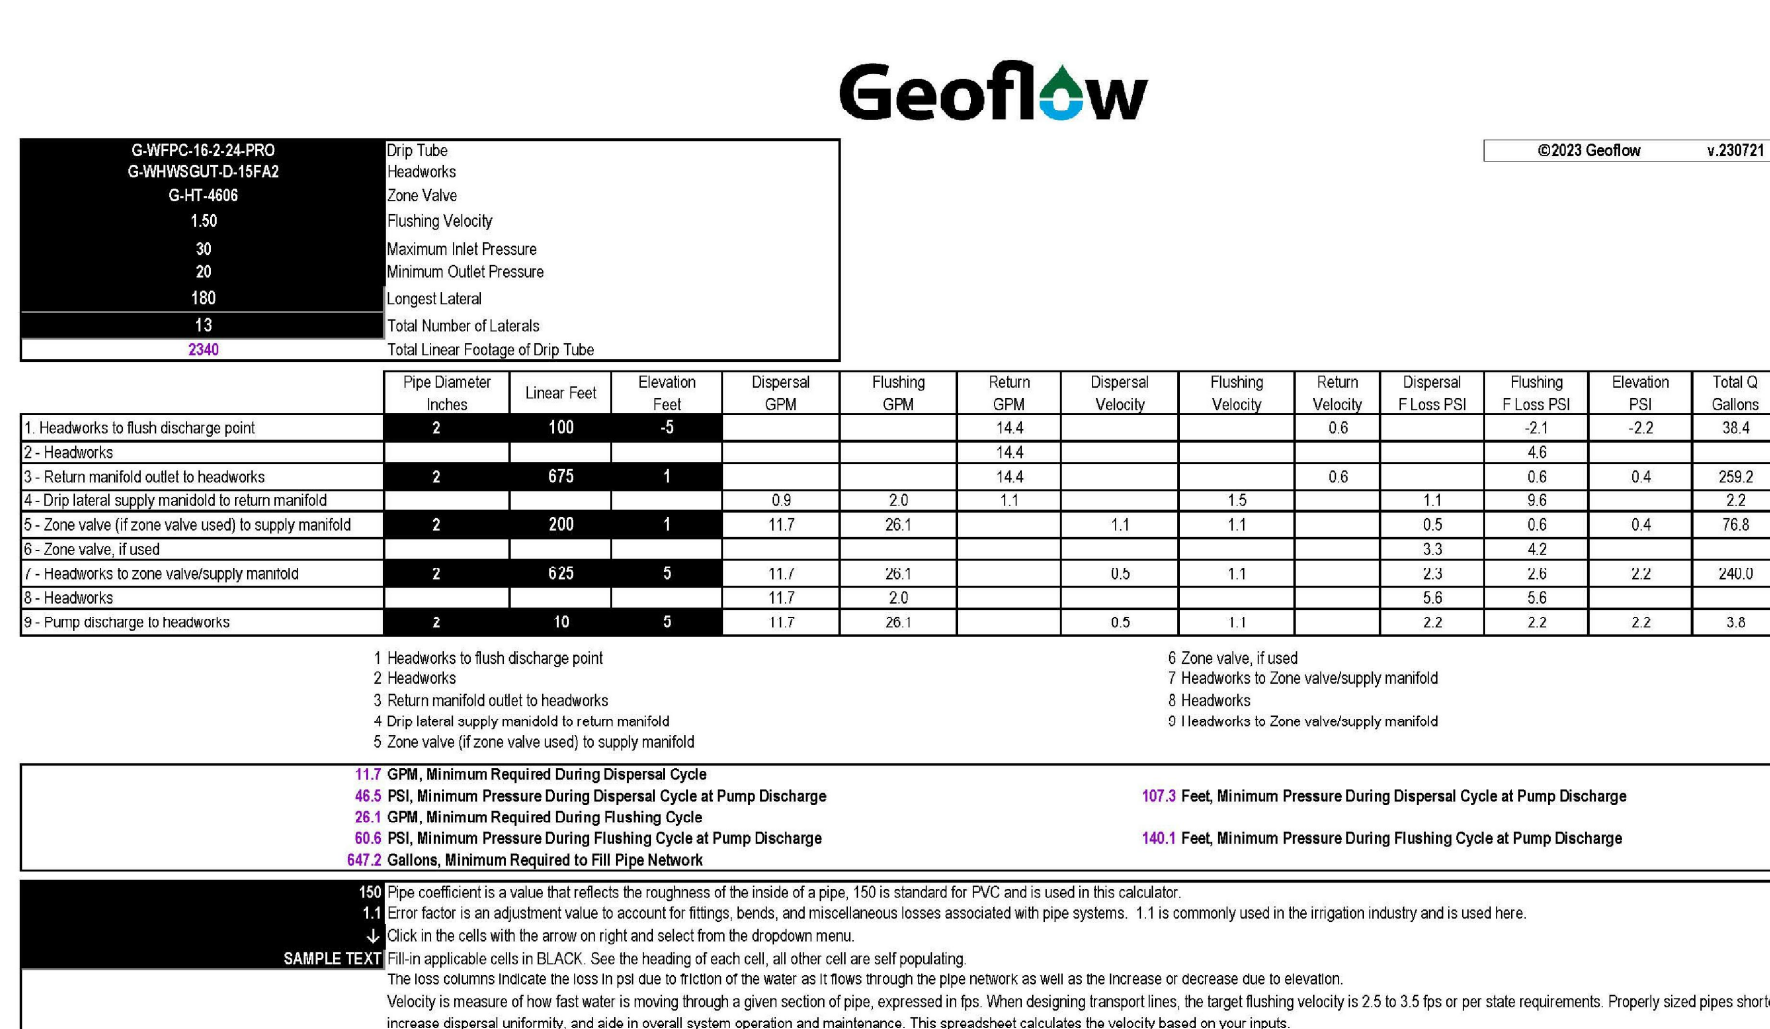


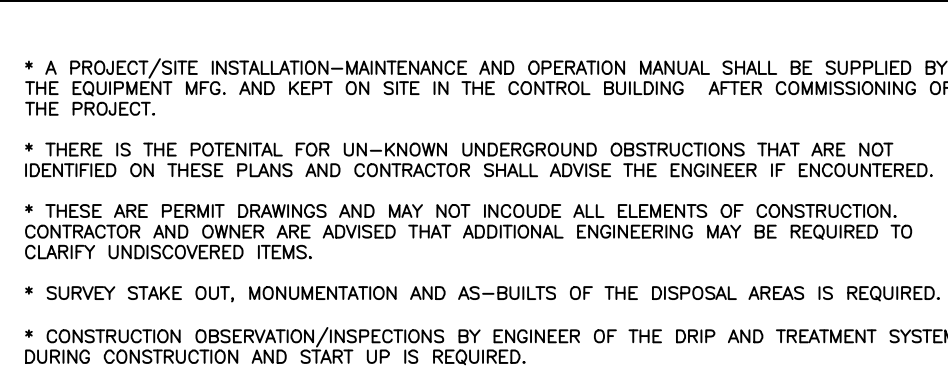

SCALE:	As Shown
DESIGNED:	CE
PLANNED:	CE
DRAWN:	MC
APPROVED:	MC
JOB:	24-240
SHEET NO. 3 OF 9	