
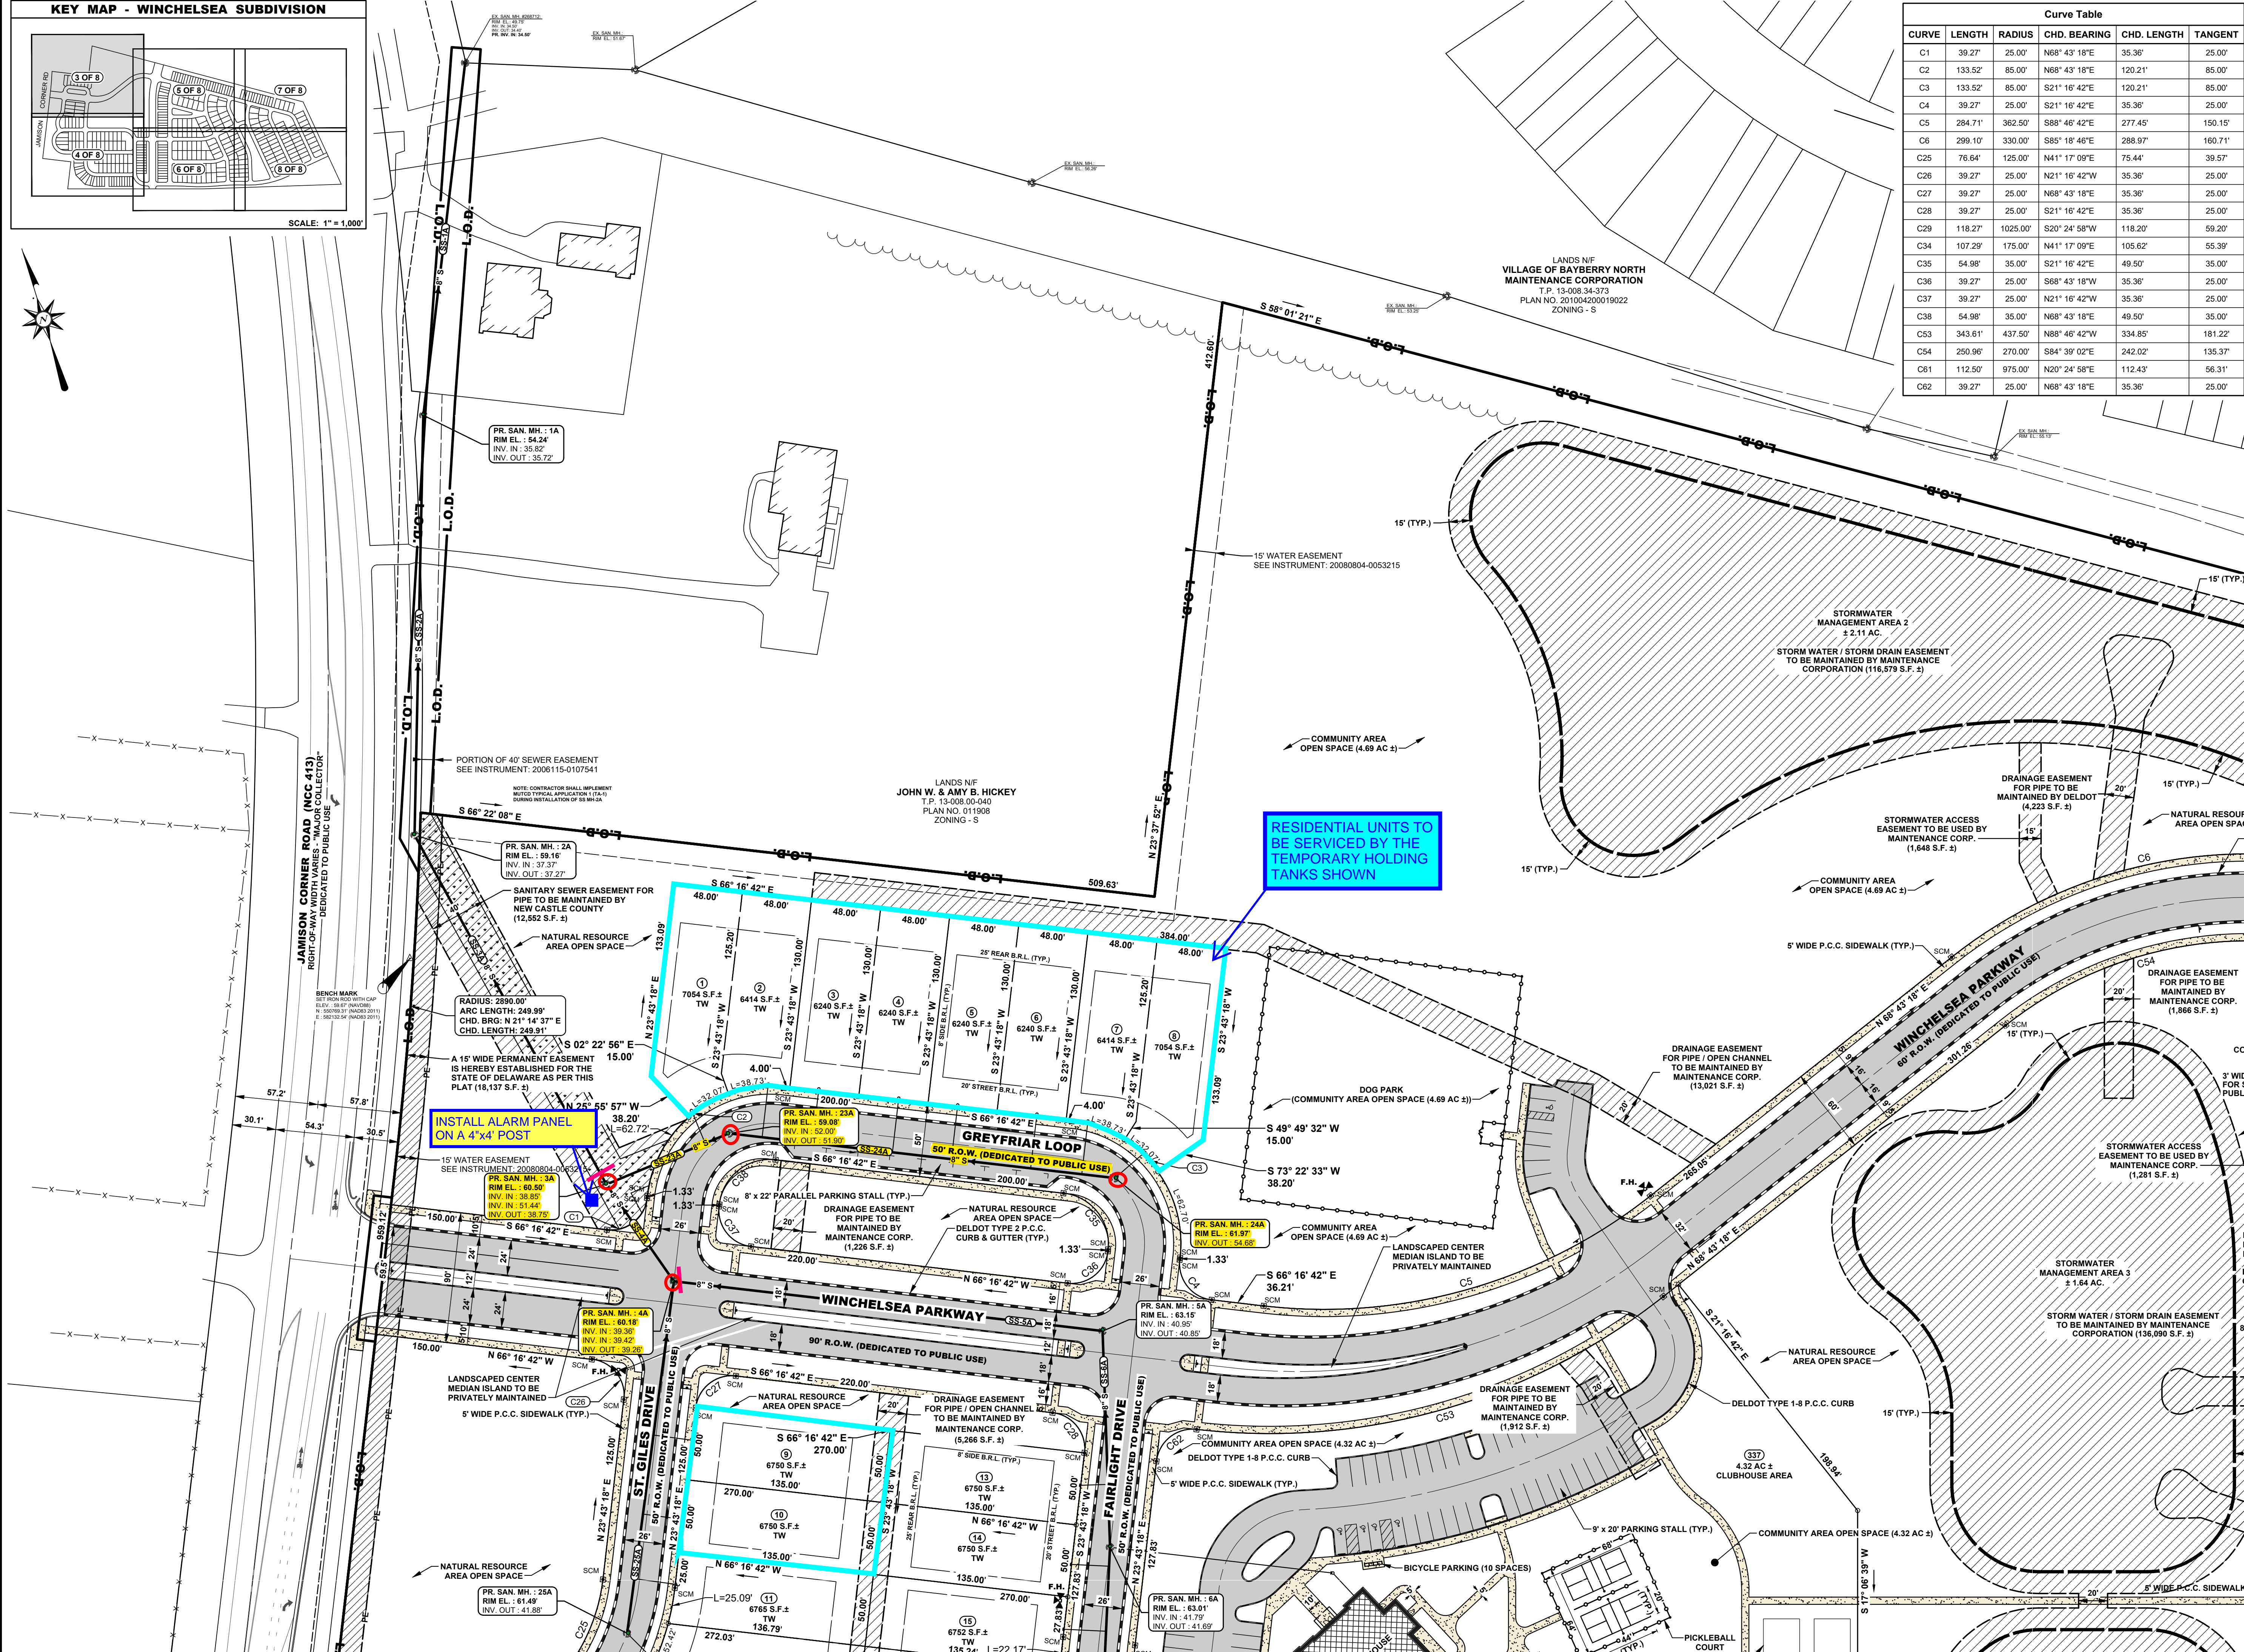


Curve Table					
CURVE	LENGTH	RADIUS	CHD. BEARING	CHD. LENGTH	TANGENT
C1	39.27	25.00	N88° 43' 18"E	35.36'	25.00'
C2	133.52	85.00	N88° 43' 18"E	120.21'	85.00'
C3	133.52	85.00	S21° 16' 42"E	120.21'	85.00'
C4	39.27	25.00	S21° 16' 42"E	35.36'	25.00'
C5	284.71	362.50	S88° 46' 42"E	277.45'	150.15'
C6	299.10	330.00	S85° 18' 46"E	288.97'	160.71'
C25	76.64	125.00	N41° 17' 09"E	75.44'	39.57'
C26	39.27	25.00	N21° 16' 42"W	35.36'	25.00'
C27	39.27	25.00	N88° 43' 18"E	35.36'	25.00'
C28	39.27	25.00	S21° 16' 42"E	35.36'	25.00'
C29	118.27	1025.00	S20° 24' 58"W	118.20'	59.20'
C34	107.29	175.00	N41° 17' 09"E	105.62'	55.39'
C35	54.98	35.00	S21° 16' 42"E	49.50'	35.00'
C36	39.27	25.00	S68° 43' 18"W	35.36'	25.00'
C37	39.27	25.00	N21° 16' 42"W	35.36'	25.00'
C38	54.98	35.00	N88° 43' 18"E	49.50'	35.00'
C53	343.61	437.50	N88° 46' 42"W	334.85'	181.22'
C54	250.96	270.00	S84° 39' 02"E	242.02'	135.37'
C61	112.50	975.00	N20° 24' 58"E	112.43'	56.31'
C62	39.27	25.00	N88° 43' 18"E	35.36'	25.00'

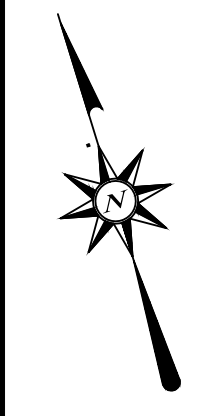

RESIDENTIAL UNITS TO BE SERVICED BY THE TEMPORARY HOLDING TANKS SHOWN


INSTALL ALARM PANEL ON A 4'x4' POST

LEGEND
 PLUG

PROJECT TITLE
 APPLICATION NO. 2024-0262-S
WINCHELSEA SUBDIVISION
 RESUBDIVISION RECORD PLAN

JAMISON CORNER ROAD
 ST. GEORGES HUNDRED
 NEW CASTLE COUNTY, DE

TEMPORARY HOLDING TANK LOCATION PLAN

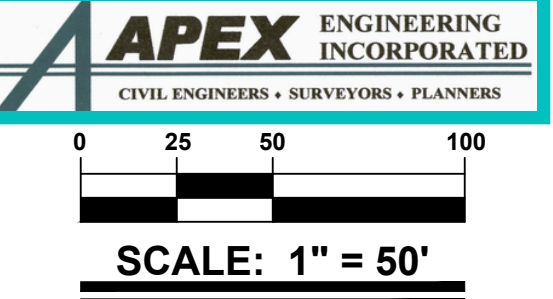

1.	06/17/24	AGENCY SUBMISSION
MARK	DATE	DESCRIPTION
PROJECT NO.:	2019202.03	
DATE:	06/14/2024	
SCALE:	1" = 50'	
DRAWN BY:	T.D.G.	PROJ. MGR.: C.D.D.
SHEET		
3 OF 8		



ARCHITECTURE
 ENGINEERING
 Delaware
 309 South Governors Avenue
 Dover, DE 19904
 302.734.7950
 The Tower at STAR Campus
 100 Discovery Boulevard, Suite 102
 Newark, DE 19713
 302.369.3700
 Maryland
 312 West Main Street, Suite 300
 Salisbury, MD 21801
 410.546.9100
 North Carolina
 3333 Jaeckle Drive, Suite 120
 Wilmington, NC 28403
 910.341.7600
 www.beckermorgan.com



CIVIL ENGINEERS • SURVEYORS • PLANNERS
 SCALE: 1" = 50'